


A.TESA
ARCHITECTURE

174 Bellevue Ave
Suite 308 - Newport, RI 02840
T. 401 608 2286
www.atesaarchitecture.com

AIA

DIMENSIONAL
AS-BUILT SET
12/20/22

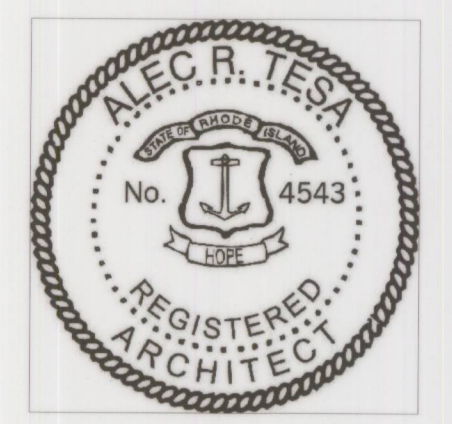

Condominium Plans
SEAVIEW TOWNHOMES CONDOMINIUM
63 Conanicus Avenue
Jamestown, Rhode Island
Assessor's Plat 8, Lot 181
Declarant: SEATH, LLC, a Rhode Island limited liability
company Survey must be certified as follows:

The Undersigned hereby certifies that this Plat Survey
contains all the information required by R.I. Gen. Laws
§34-36.1-1.09.

By: *A.TESA*
Dated: 12-20-2022

Issues

Number	Date	Description
01	12-20-22	DIMENSIONAL AS-BUILTS

RECEIVED FOR RECORD
ROBERTA J. FASAN
TOWN CLERK
JAMESTOWN, R.I.
JAN 11, 2023 11:47 AM
Vol: 1030 Pg: 221

Checked by: AT
Drawn by: RM
Project Number: -

Revisions

Number	Date	Description
--------	------	-------------

SEAVIEW
TOWNHOMES
CONDOMINIUM

63 Conanicus Avenue
Jamestown, RI

Drawing Scale: AS NOTED
Date Issued: 12/30/2022

EXTERIOR
ELEVATIONS

A3.2

